



NOTE: THESE ARE AN EXISTING OLD WATERLINE RUNNINGS TO THE BUILDING (CURRENTLY NOT IN USE). EXISTING OLD WATERLINE MAY BE REMOVED IF NECESSARY FOR INSTALLATION OF NEW WATERLINE.

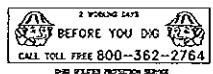

NON MEMBERS MUST BE CONTACTED DIRECTLY. THE LOCATION BOTH HORIZONTAL AND VERTICAL OF THE EXISTING UNDERGROUND UTILITIES SHOWN HEREON, HAVE BEEN OBTAINED BY A DILIGENT AND COMPREHENSIVE SEARCH OF AVAILABLE RECORDS. VERIFICATION BY FIELD OBSERVATION HAS BEEN CONDUCTED WHERE PRACTICAL. HOWEVER, BARRINGTON CONSULTING GROUP, INC. DOES NOT GUARANTEE THE COMPLETENESS, NOR ACCURACY THEREOF.

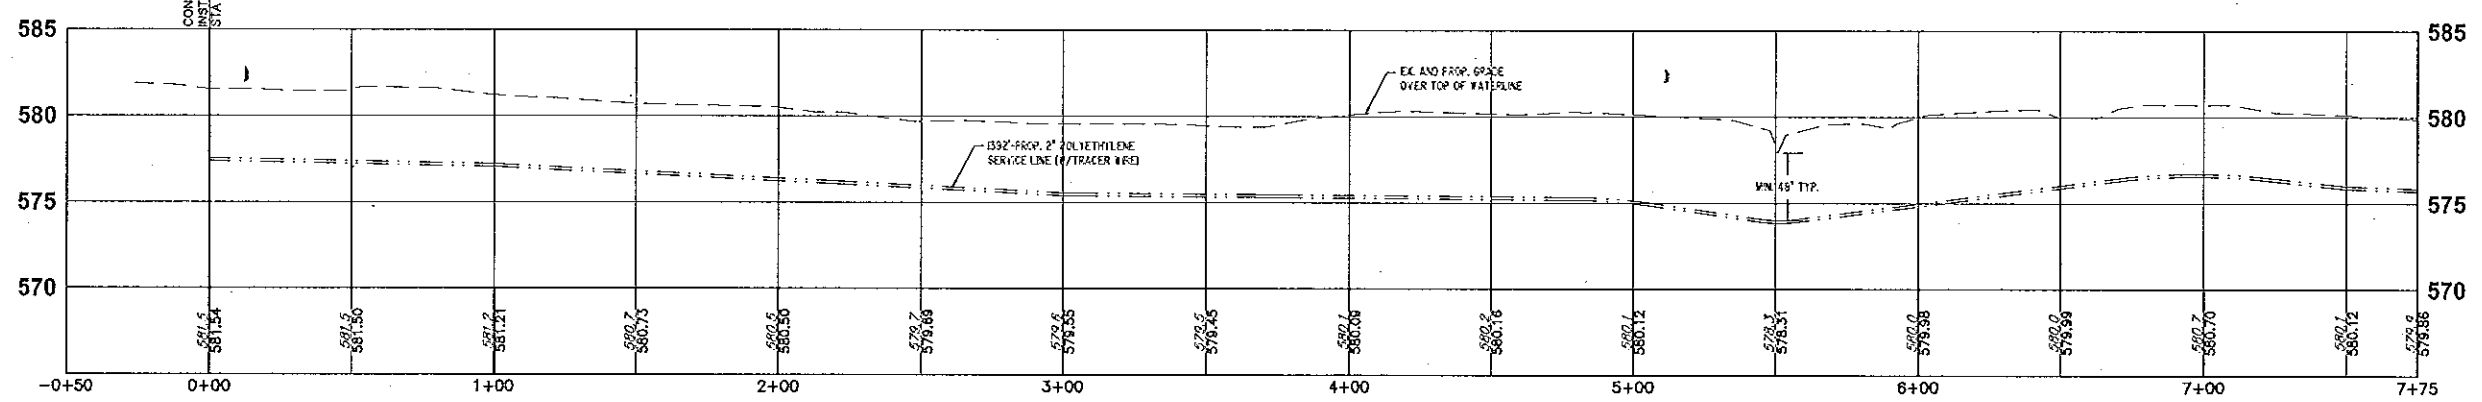

**GENERAL NOTES**

THE LAKE COUNTY DEPARTMENT OF UTILITIES WATER SERVICE CONNECTION PROCEDURES SHALL GOVERN THIS PROJECT.  
 ALL WORK CONTEMPLATED UNDER THIS CONTRACT SHALL COMPLY WITH THE U.S. DEPARTMENT OF LABOR OCCUPATIONAL SAFETY AND HEALTH ACT.  
 STATIONING SHOWN HEREON IS ALONG THE CENTERLINE OF THE PROPOSED WATERLINE.  
 ALL EXISTING PROFILES SHOWN HEREON ARE FROM ACTUAL FIELD SURVEYS BY BARRINGTON CONSULTING GROUP, INC.  
**HAUL ROADS**  
 ALL HAUL ROADS SHALL REMAIN IN GOOD DRIVING CONDITION. STREET CLEANING SHALL BE PERFORMED AS NECESSARY, AS DIRECTED BY THE OWNER. THE CONTRACTOR SHALL BE RESPONSIBLE FOR KEEPING ROADWAYS CLEAN OF ALL DEBRIS ASSOCIATED WITH THE IMPROVEMENTS.  
**TRAFFIC CONTROL**  
 THE CONTRACTOR SHALL BE RESPONSIBLE FOR ALL CONSTRUCTION SIGNS, TRAFFIC MAINTENANCE AND TRAFFIC CONTROL AS DIRECTED BY THE OWNER. ALL WORK, SIGN LAYOUTS, AND MATERIALS USED SHALL CONFORM TO THE SPECIFICATIONS SET FORTH IN THE OHIO MANUAL OF UNIFORM TRAFFIC CONTROL DEVICES. ACCESS TO GREAT LAKES POWER BUILDING SHALL BE MAINTAINED AT ALL TIMES.

**MATERIAL SPECIFICATIONS**

MATERIAL SPECIFICATIONS CALLED FOR ON THE PLANS REPRESENT THE MINIMUM REQUIRED FOR EACH APPLICATION. THE OWNER MAY REQUEST OR THE CONTRACTOR MAY DESIRE TO SUBSTITUTE ALTERNATE MATERIALS. ANY SUCH SUBSTITUTIONS MUST BE EQUIVALENT IN QUALITY TO THE MATERIAL CALLED FOR AND MUST BE APPROVED IN WRITING BY THE APPROVING AGENCIES AND THE CONSULTING ENGINEER.  
 2\"/>

**MATERIAL TESTING AND PERMITS**

THE CONTRACTOR SHALL BE RESPONSIBLE FOR THE COST OF ALL MATERIAL TESTING AND ALL PERMITS REQUIRED FOR THIS PROJECT.

**SEEDING AND MULCHING**

ALL SEEDING AND MULCHING SHALL BE PERFORMED IN ACCORDANCE WITH THE REQUIREMENTS OF THE STANDARD SPECIFICATIONS OF THE OHIO DEPARTMENT OF TRANSPORTATION, LATEST EDITION, ODOT ITEM 659.

**SEEDING MIXTURE:**

TYPE 1 - 3 LBS. / 1000 SQ. FT.	
KENTUCKY BLUEGRASS	40%
CREeping RED FESCUE	40%
PERENNIAL RYE	20%
FERTILIZER	12-2-2, 20#/1000 SF
MULCH	2 TONS PER ACRE


SEDIMENT CONTROL SHALL BE ACCOMPLISHED BY SEEDING AND MULCHING ALL DISTURBED AREAS IMMEDIATELY UPON COMPLETION OF EXCAVATION OR FILL AND FINISHED GRADING IN ACCORDANCE WITH ITEM 659, OHIO DEPARTMENT OF TRANSPORTATION CONSTRUCTION AND MATERIAL SPECIFICATIONS AND/OR AS DIRECTED BY THE LAKE COUNTY SOIL AND WATER CONSERVATION DISTRICT.

RESTORATION OF ALL DISTURBED AREAS SHALL IMMEDIATELY FOLLOW GRADING OPERATIONS. DELAY IN RESTORATION SHALL NECESSITATE TEMPORARY EROSION CONTROL MEASURES APPROVED BY THE LAKE COUNTY SOIL AND WATER CONSERVATION DISTRICT AND AT THE CONTRACTOR'S COST.


**UTILITIES**

IT IS THE OBLIGATION AND RESPONSIBILITY OF THE CONTRACTOR TO MAKE HIS OWN INVESTIGATIONS OF SURFACE AND SUBSURFACE CONDITIONS PRIOR TO SUBMITTING HIS PROPOSAL.


THE LOCATION OF ALL EXISTING UNDERGROUND UTILITY FACILITIES ARE SHOWN ON THE PLANS FROM DATA AVAILABLE AT THE TIME OF THE FIELD SURVEY IN ACCORDANCE WITH SECTION 153.64 OF THE OHIO REVISED CODE. THE CONTRACTOR SHALL BE RESPONSIBLE FOR NOTIFICATION OF THE EXISTING UTILITY OWNERS AND UTILITY PROTECTION SERVICE IN ACCORDANCE WITH SECTION 154.64 OF THE O.R.C. AND AS OUTLINED IN PROJECT SPECIFICATIONS.

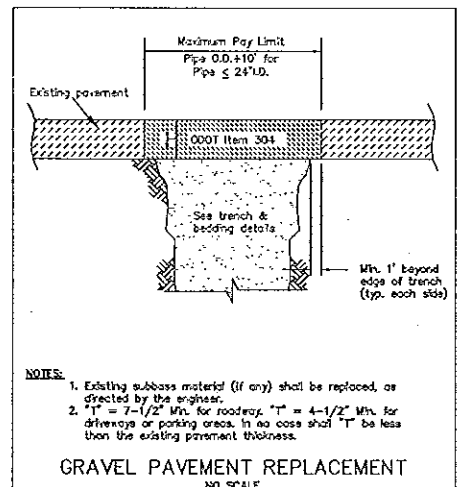

NOTES:  
 1. Existing subbase material (if any) shall be replaced, as directed by the engineer.  
 2. 1\"/>

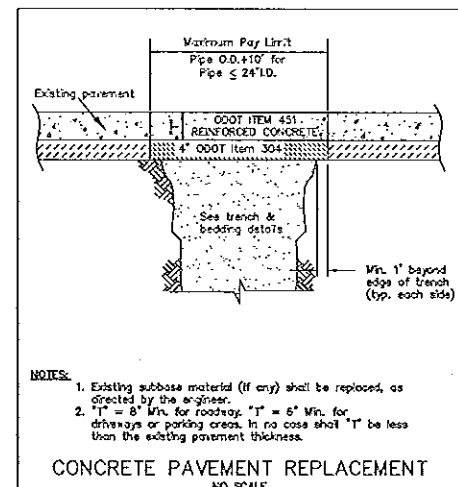

NOTES:  
 1. Existing subbase material (if any) shall be replaced, as directed by the engineer.  
 2. 1\"/>

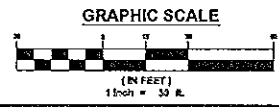

15052

REVISIONS	BY

**Barrington**  
 CONSULTING GROUP, INC.  
 9114 TYLER BLVD., MENTOR, OHIO 44060  
 PHONE: 440.205.1260 FAX: 440.205.1262  
 www.BarringtonCGI.com

**MIDWEST MATERIALS**  
 MELISSA EVENHIEMER  
 P.O. BOX 345  
 PERRY, OHIO 44081  
 PH: 440-259-5200 / FAX: 440-259-5204

**2\"/>
 MIDWEST MATERIALS STEEL SERVICE CENTER  
 3695 SHEPARD ROAD, PERRY, OHIO  
**SITE PLAN****

DATE: **AUGUST 6, 2015**  
 SCALE: **1\"/>
 SHEET: **112**  
 OF SHEETS**