
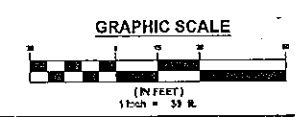


MEMBERS MUST BE CONTACTED DIRECTLY
 THE LOCATION BOTH HORIZONTAL AND VERTICAL OF THE EXISTING UNDERGROUND UTILITIES SHOWN HEREON HAVE BEEN OBTAINED BY A DIRECT AND COMPREHENSIVE SEARCH OF AVAILABLE RECORDS. VERIFICATION BY FIELD OBSERVATION HAS BEEN CONDUCTED WHERE PRACTICAL. HOWEVER, BARRINGTON CONSULTING GROUP, INC. DOES NOT GUARANTEE THE COMPLETENESS, NOR ACCURACY THEREOF.

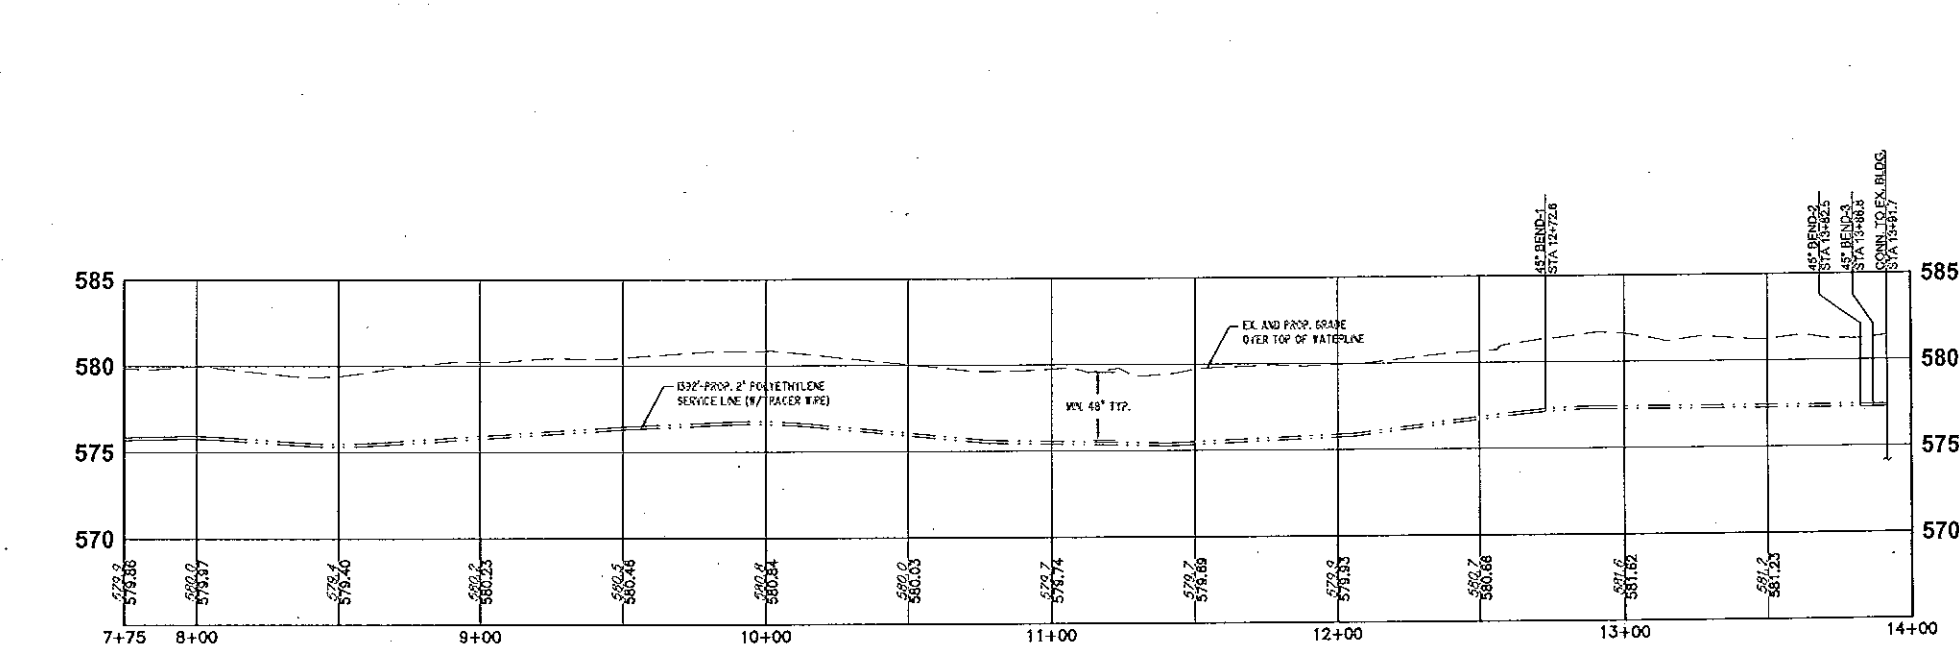

REVISIONS	BY

Barrington
 CONSULTING GROUP, INC.
 9114 TYLER BLVD., MENTOR, OHIO 44060
 PHONE 440.205.1260 FAX 440.205.1262
 www.BarringtonCGI.com

MIDWEST MATERIALS
 MELISSA EVENHEIMER
 P.O. BOX 345
 PERRY, OHIO 44081
 PH: 440-259-5200 / FAX: 440-259-5204

2" WATER SERVICE LINE
 MIDWEST MATERIALS STEEL SERVICE CENTER
 3695 SHEPARD ROAD, PERRY, OHIO
 SITE PLAN

DRAWN BY: LKS
 CHECKED BY: DYN
 DATE: AUGUST 6, 2015
 SCALE: 1" = 30'
 JOB NO: 15052
 SHEET: 2/2
 OF SHEETS

15052